


SECOND FLOOR AS-BUILT
06/19/09 NOT TO SCALE

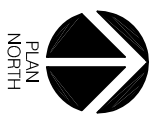

GOODYEAR FINANCIAL CENTER 2
GOODYEAR, AZ